


# SAMPLE - RED LINE DRAWING

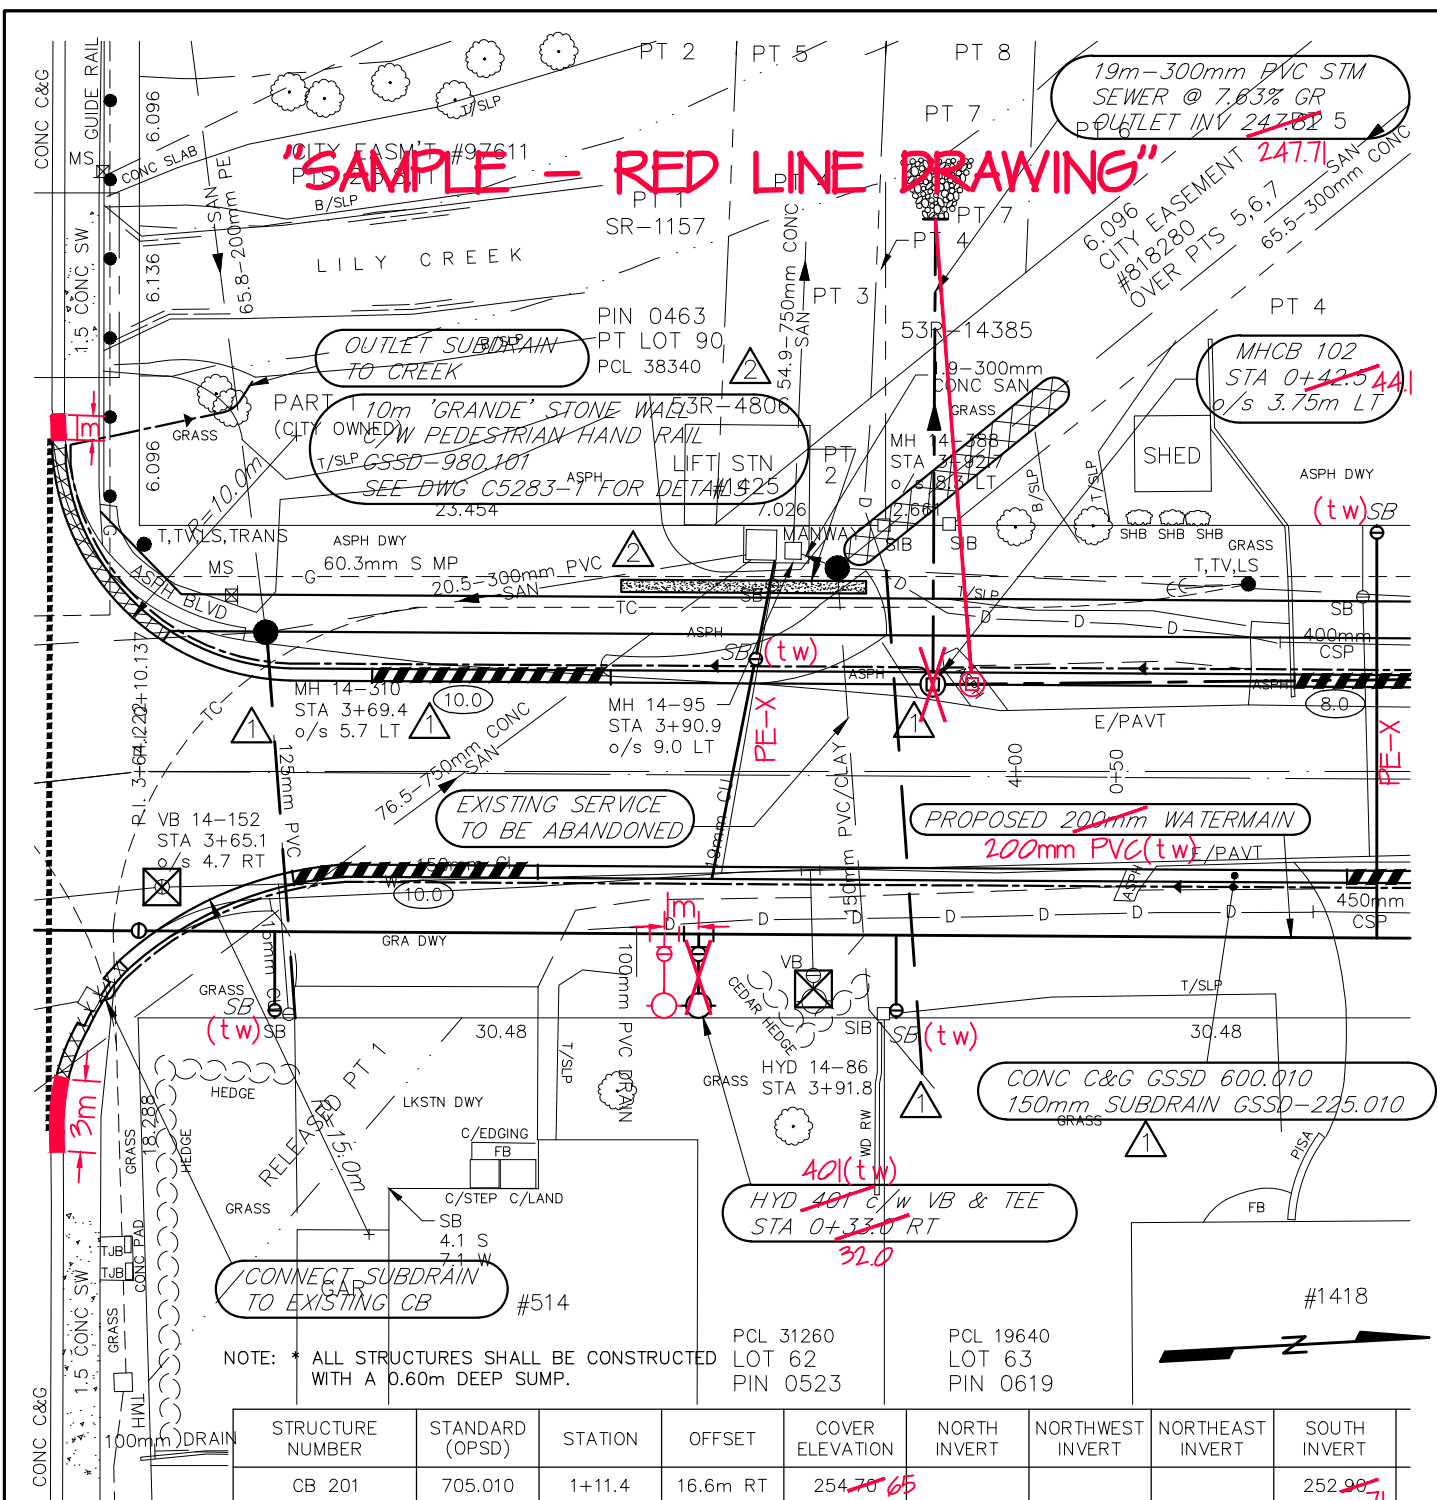

NOTE: \* ALL STRUCTURES SHALL BE CONSTRUCTED WITH A 0.60m DEEP SUMP.

STRUCTURE NUMBER	STANDARD (OPSD)	STATION	OFFSET	COVER ELEVATION	NORTH INVERT	NORTHWEST INVERT	NORTHEAST INVERT	SOUTH INVERT
CB 201	705.010	1+11.4	16.6m RT	254.70 <del>65</del>				252.90 <del>71</del>
MHCB 101	701.010	1+05.0	13.0m RT	254.40 <del>54</del>	252.69 ✓			
DBLCB 202	703.021	0+90.5	3.75m LT	253.24 ✓		249.36 <del>39</del>		251.35 ✓
MHCB 102	701.010	0+42.5 <del>44.1</del>	3.75m LT	251.86 <del>51</del>				



## SAMPLE RED LINE DRAWING

DRAWN BY: BWK	REV No:
DATE: 2012-04-24	REV DATE:
SCALE: N.T.S.	CAD/FILE No.: <b>A2251-1</b>
APP'D:	(1 OF 1)

DISCLAIMER OF WARRANTY : The data is provided "as-is", without warranty of any kind either expressed or implied. Any and all liabilities for damage, direct or indirect, however caused, and resulting in any way by use of the supplied data is the full and final responsibility of the user.

COPYRIGHT : All rights are reserved. No part of the supplied data may be reproduced, or transmitted to others, in any form or by any means, without the prior written permission of the CITY OF GREATER SUDBURY.